


1775 US Hwy 59 S.E.  
Thief River Falls, MN 56701

THIEF RIVER FALLS FLOOR PLAN

SCALE: NTS

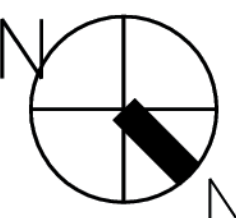

09/07/07