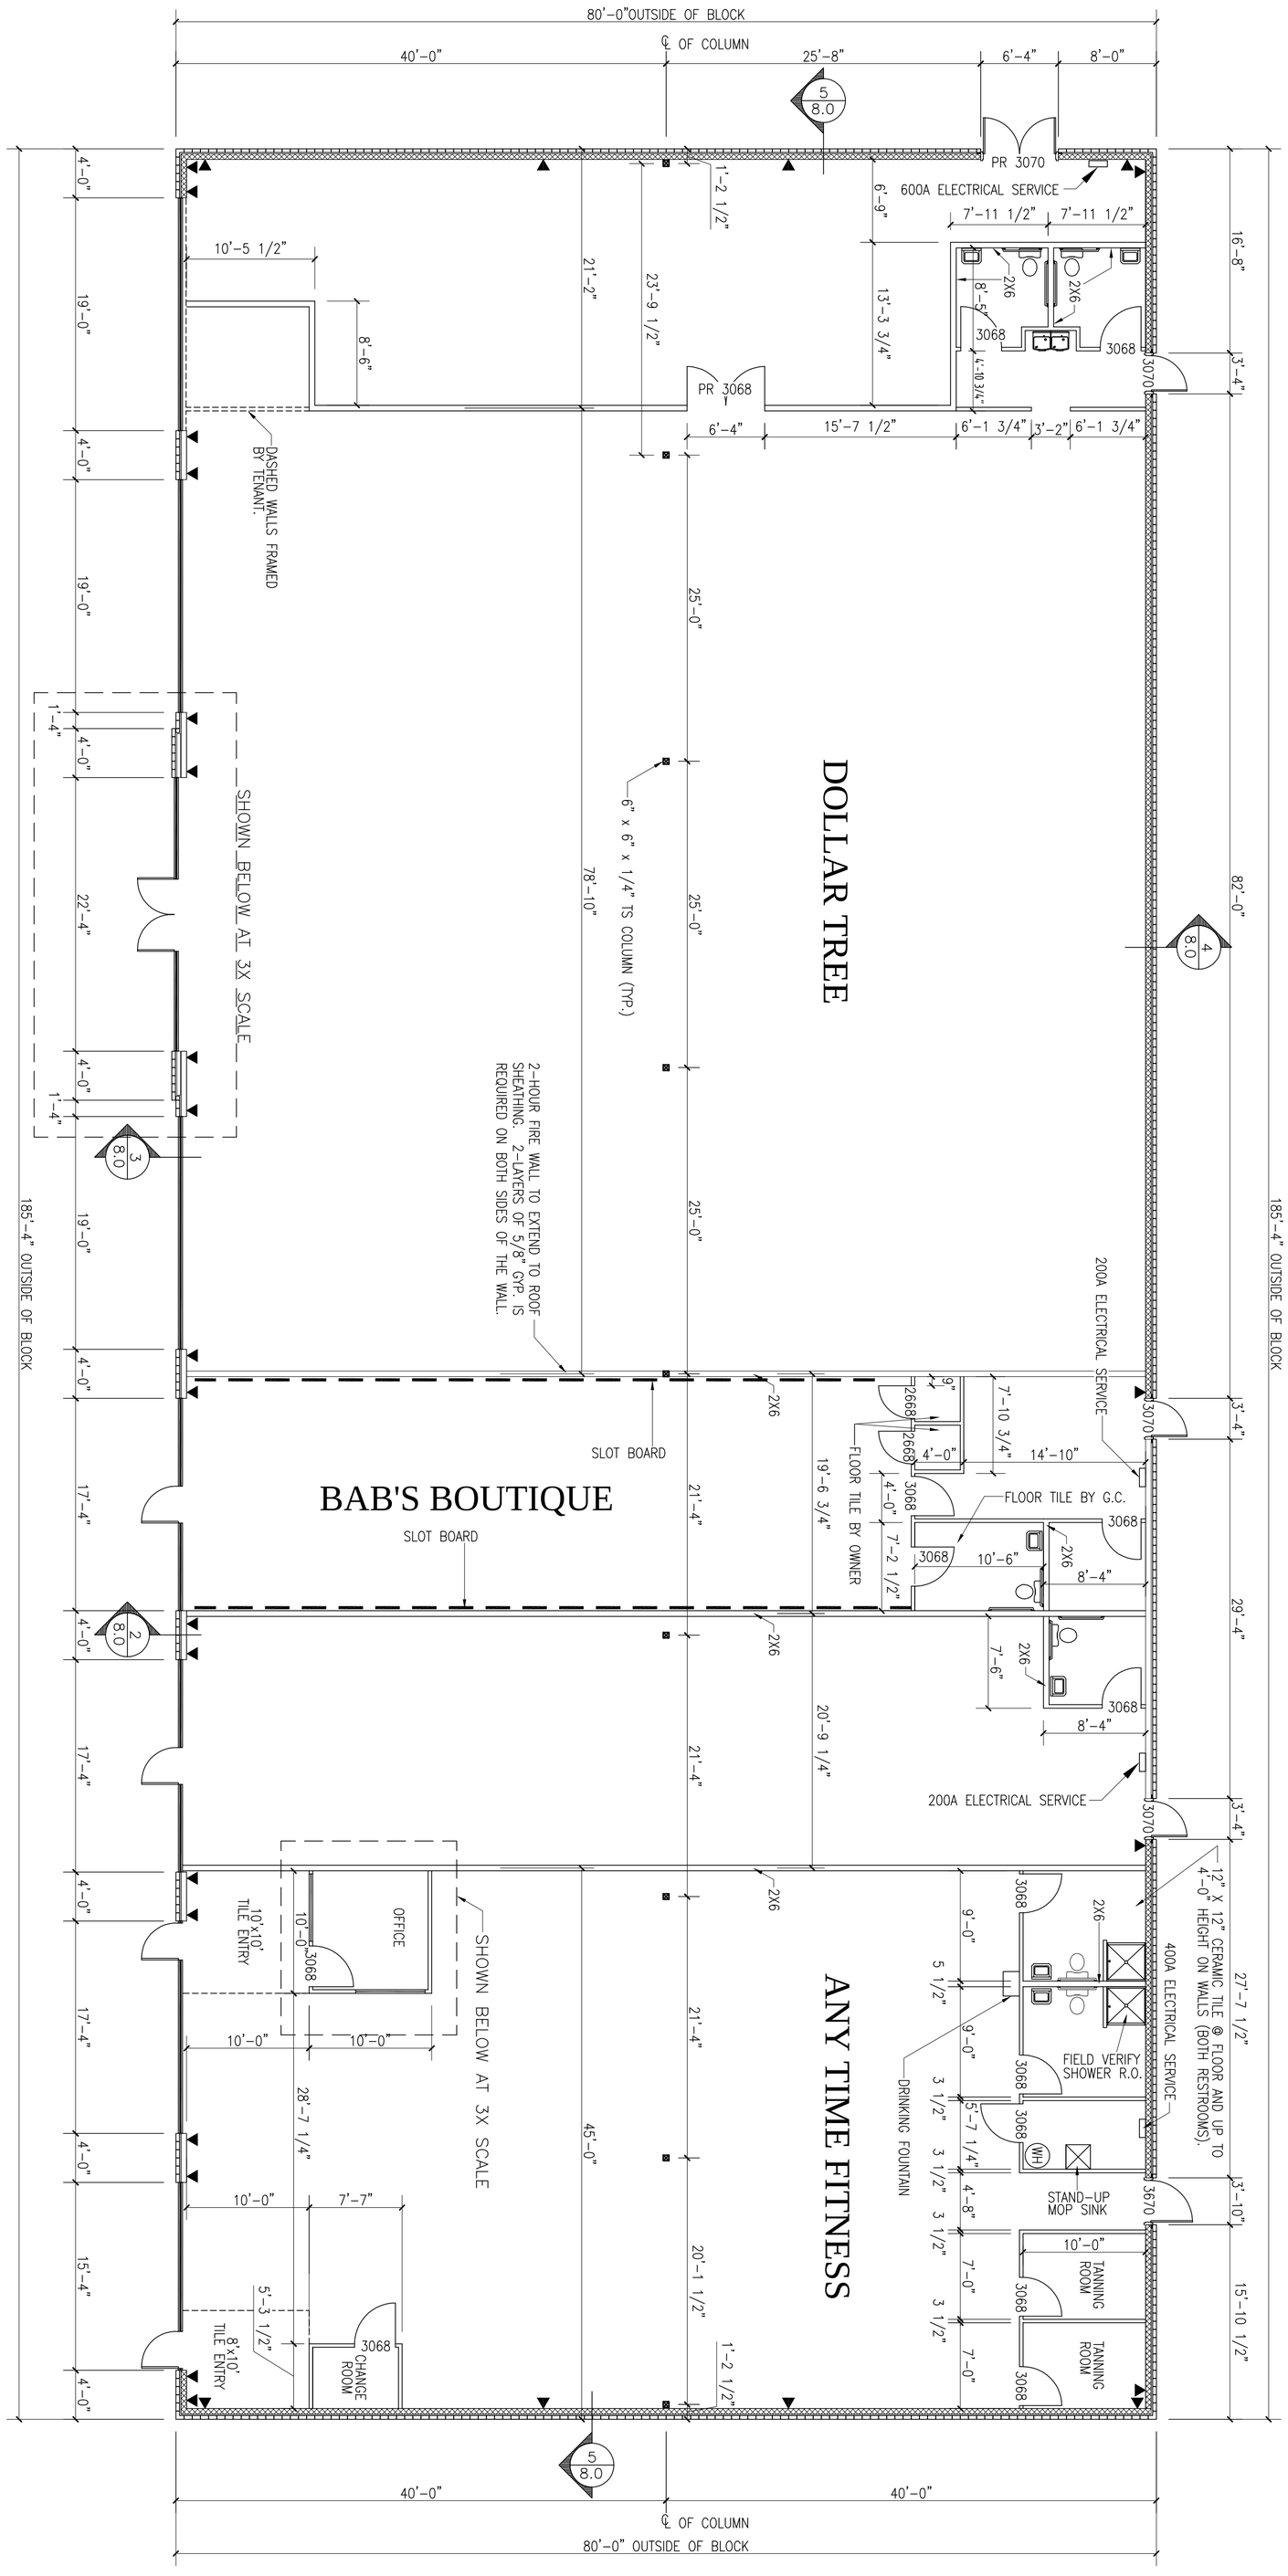

#		Engineer	Project Name	Project Tracking
1		**OS Engineering** *Quality Engineering & Project Management* OS Engineering, LLC 5731 W. Hwy 60 Suite 200 Brookline, MO 65619 *phone:* 417.831.1468 *fax:* 417.865.7891		Revisions: 1 2 3 4 5 Const. Issue: Issue Date: 05/16/08 Checked By: Drawn By: CMB Job No:

THIS DRAWING IS THE PROPERTY OF OS ENGINEERING, LLC AND SHALL NOT BE USED, COPIED OR REPRODUCED WITHOUT THE OWNER'S WRITTEN PERMISSION.